
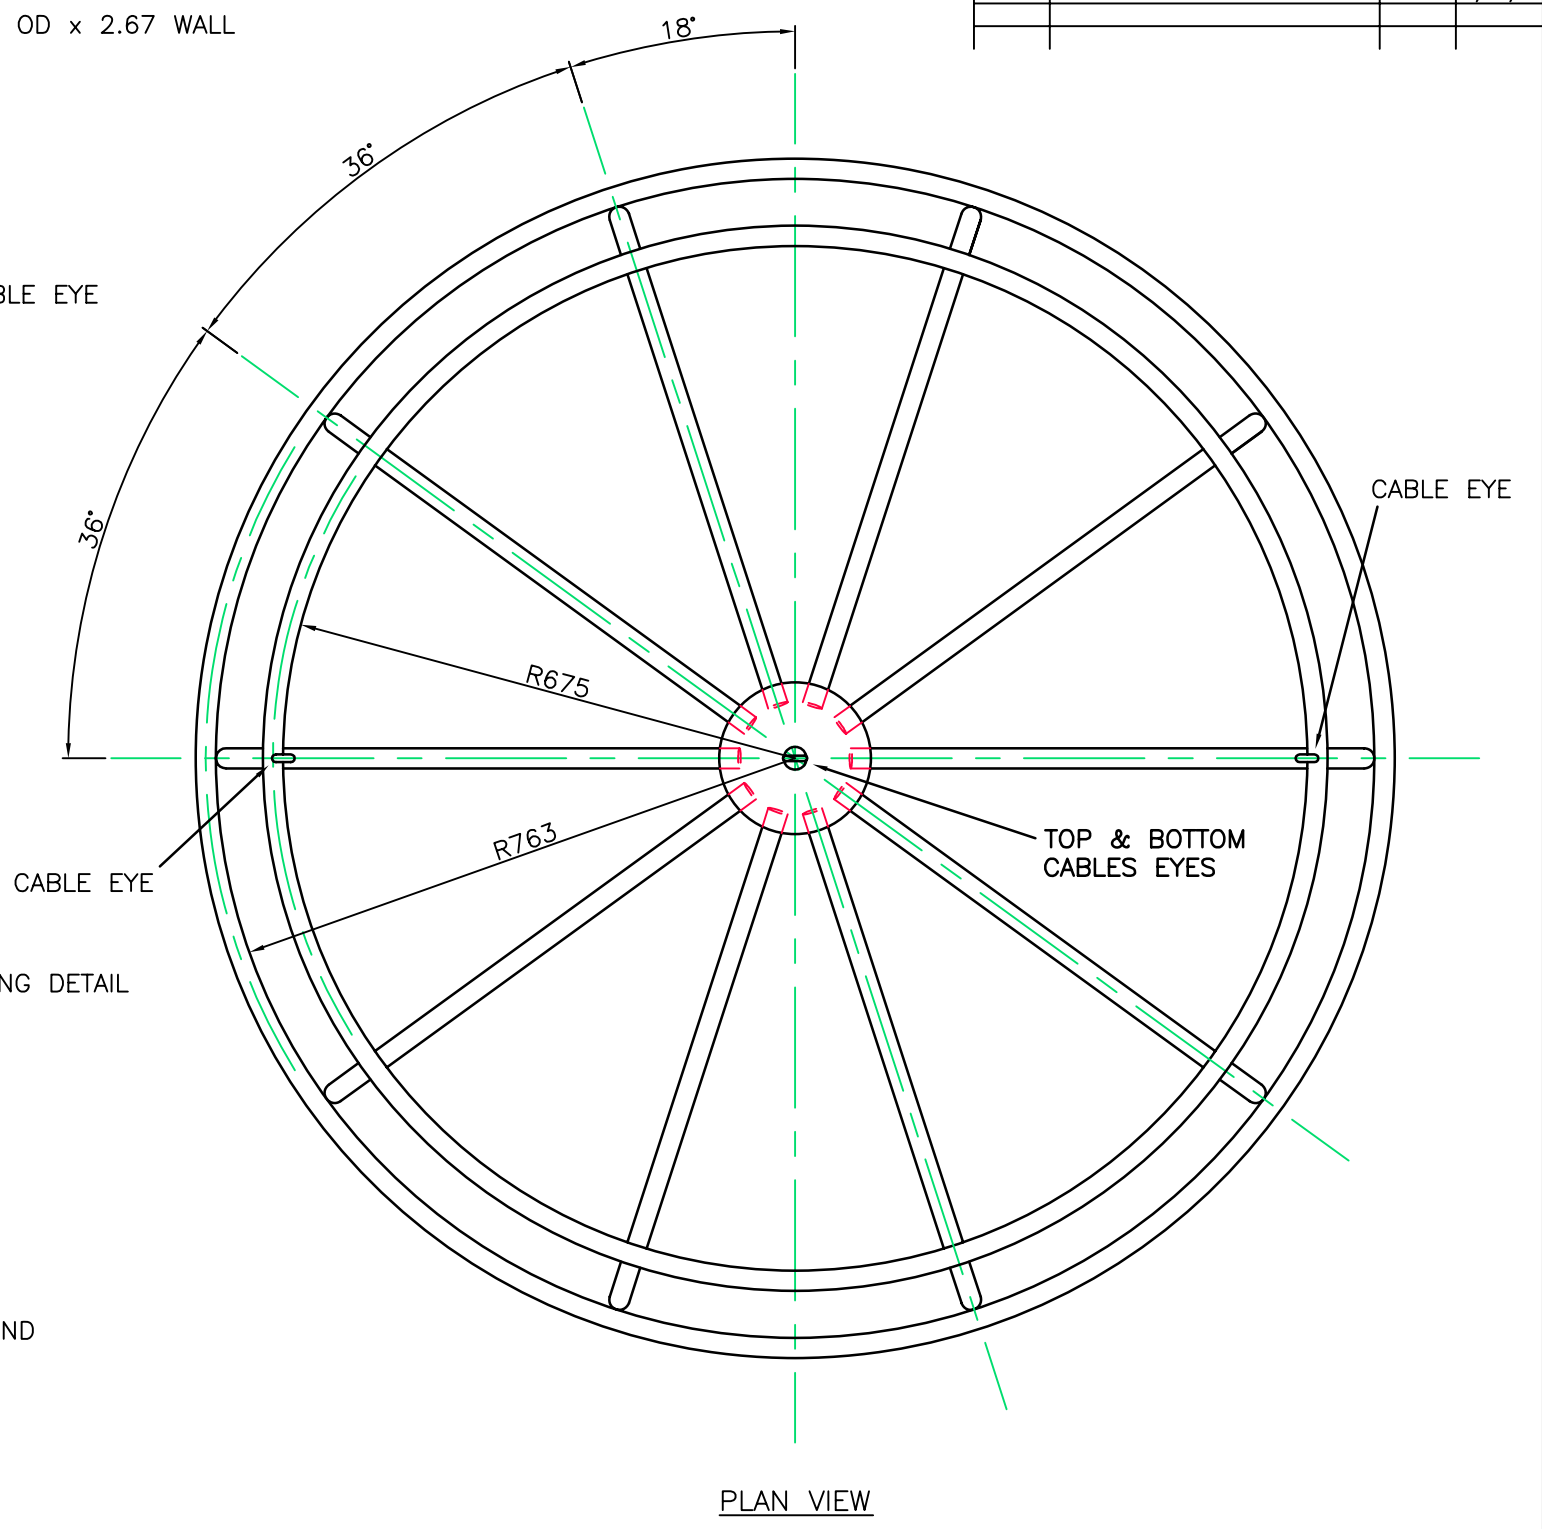


THIS DRAWING IS THE PROPERTY OF BENSON-SEDGWICK ENG. LTD.  
IT IS A CONFIDENTIAL DOCUMENT AND MUST NOT BE COPIED, USED  
OR ITS CONTENTS DIVULGED WITHOUT PRIOR WRITTEN CONSENT

REV.	DESCRIPTION	DRN.	DATE
A	ISSUED FOR APPROVAL	JP	31/07/03
B	DRAWING COMPLETED	JP	10/11/03
C	GENERAL AMMENDMENTS	JP	15/12/03
D	EMBLEM FIXING NOTE ADDED	JP	04/02/04
E	AS BUILT & FIXED ISSUE	JP	10/08/04

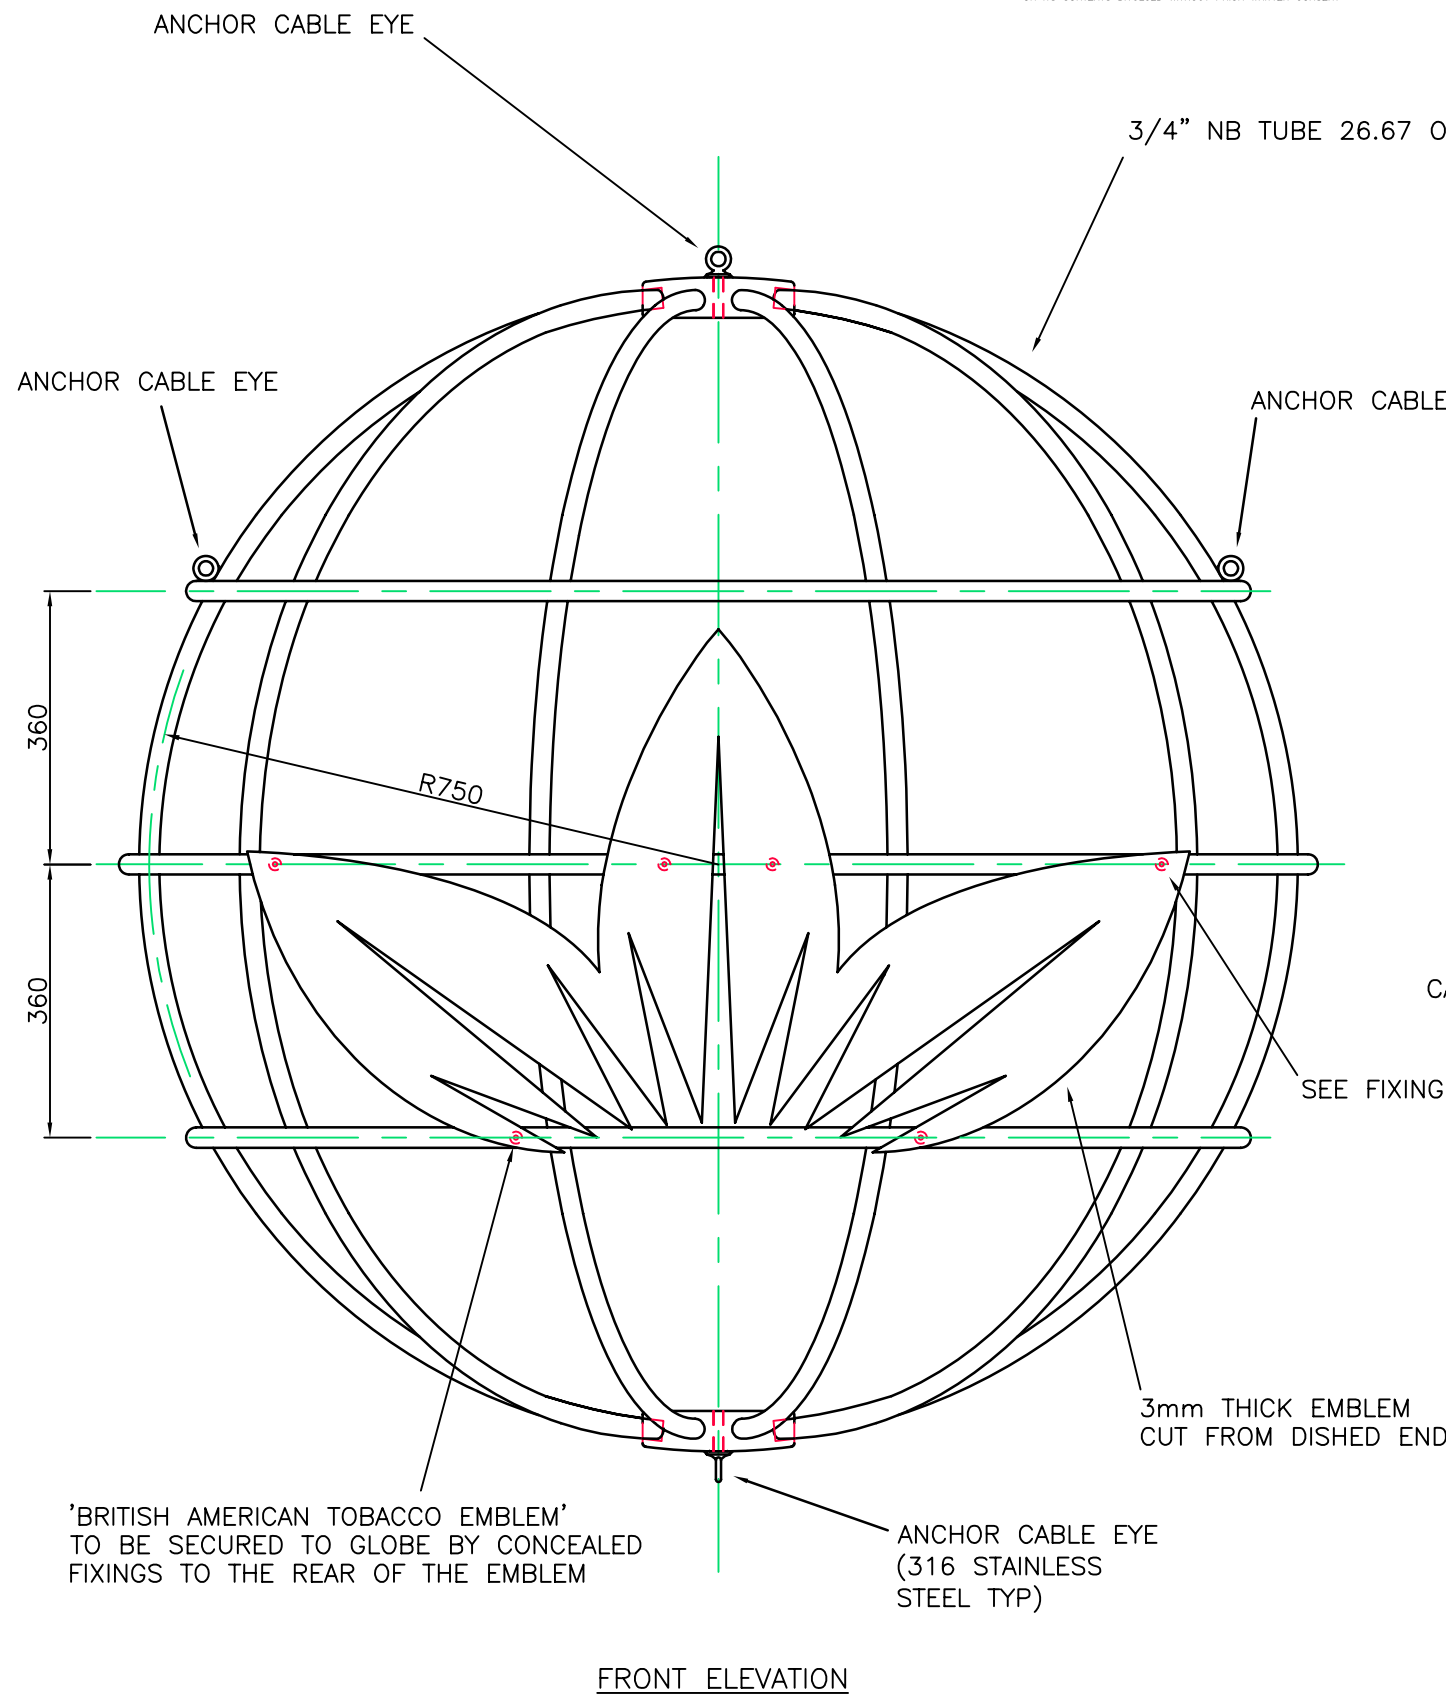

'BRITISH AMERICAN TOBACCO EMBLEM'  
TO BE SECURED TO GLOBE BY CONCEALED  
FIXINGS TO THE REAR OF THE EMBLEM

3mm THICK EMBLEM  
CUT FROM DISHED END

ANCHOR CABLE EYE  
(316 STAINLESS  
STEEL TYP)

SEE FIXING DETAIL

FRONT ELEVATION

PLAN VIEW

**GENERAL NOTES**  
MANUFACTURED FROM 316L STAINLESS STEEL THROUGHOUT.  
TOP & BOTTOM DISHES, TUBES AND TUBE JUNCTION PIECES ALL  
SATIN POLISHED.  
EMBLEM FINISHED IN GOLD LEAF BY BENSON-SEDGWICK

1-OFF ENTRANCE GLOBE SCULPTURE  
IBEX INTERIORS LTD  
BAT GLOBE HOUSE

**BENSON-SEDGWICK ENGINEERING LTD**  
Selinas Lane . Dagenham . Essex . RM8 1QE  
Telephone: 020 8593 0212 - 020 8593 7314 Fax: 020 8592 8240  
Email: mail@benson-sedgwick.co.uk Web: www.benson-sedgwick.co.uk

Drawn : JP	Date : 30/07/03	Dimensions : mm
Checked :	Date :	Scale : 1:5
Drg. No. 16406	Sheet No. 1	Rev. E